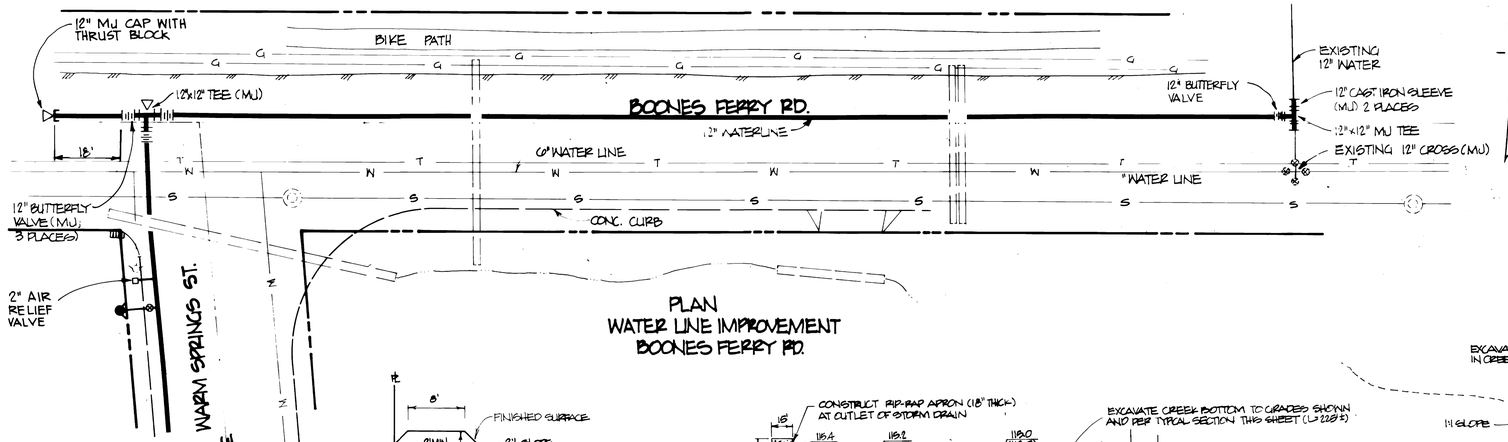

PLAN
WATER LINE IMPROVEMENT
BOONES FERRY RD.

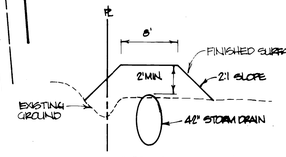

TYPICAL SECTION
STA. 0+28
STORM DRAIN LINE A

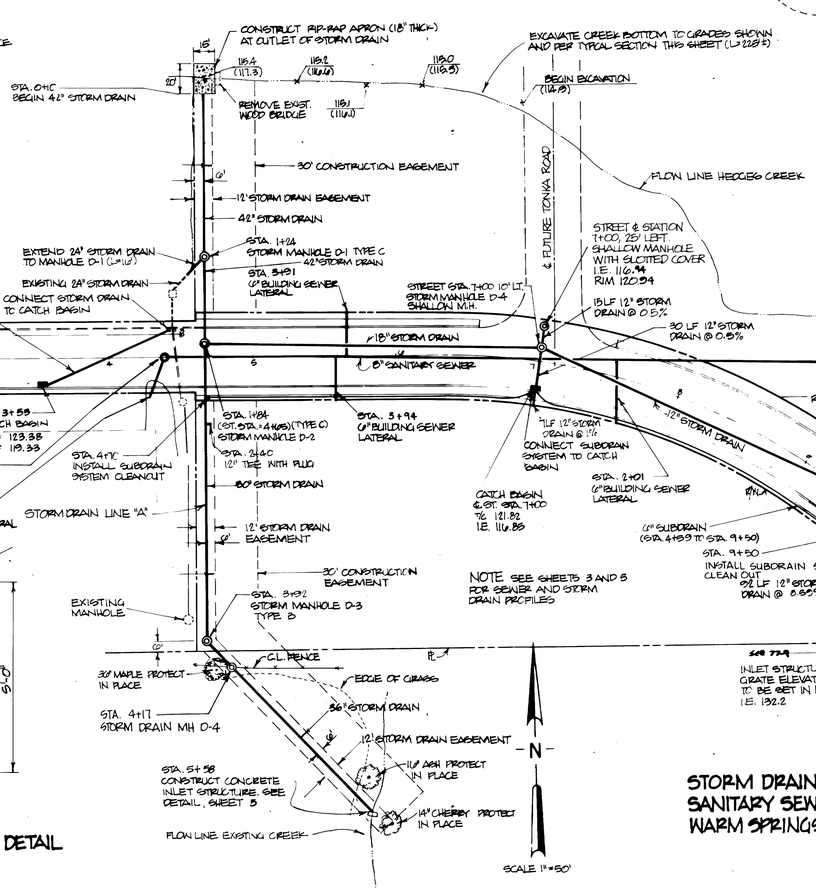

NOTE: SEE SHEET 3 FOR STREET, LIGHTING AND WATER IMPROVEMENTS

NOTE SEE SHEETS 3 AND 5 FOR SEWER AND STORM DRAIN PROFILES

STORM DRAIN AND SANITARY SEWER PLAN
WARM SPRINGS STREET

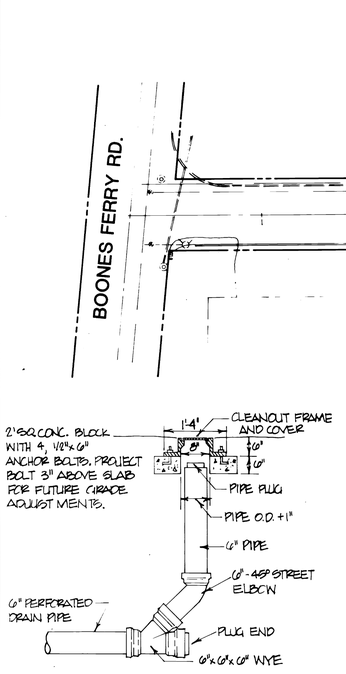

SUBDRAIN SYSTEM CLEANOUT

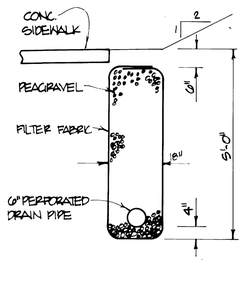

SUBDRAIN SYSTEM DETAIL
1/2" = 1'-0"

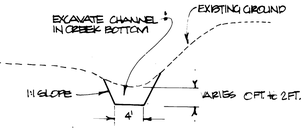

TYPICAL SECTION
HEDGES CREEK
SCALE 1"=10' HORIZ.
1"= 5' VERT.

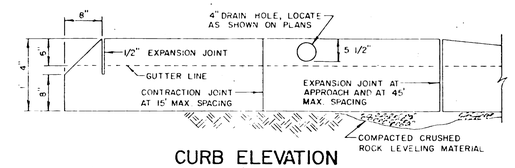

CURB ELEVATION

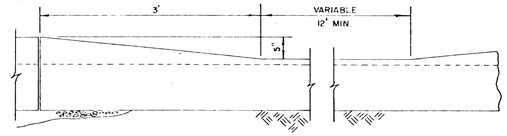

APPROACH ELEVATION

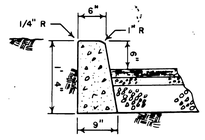

STANDARD CURB

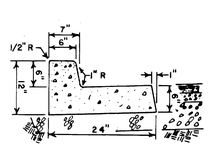

CONC. CURB & GUTTER

NOTE: SIDEWALK RAMP SHALL BE CENTERED ON CURB RETURN

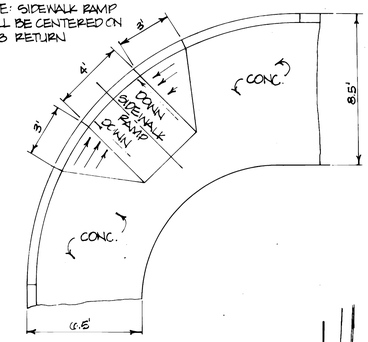

SIDEWALK RAMP

85-4-4

DATE	JULY 1983		
DESIGNER	HHR		
DRAFTSMAN	JRH		
REVIEWER	HHR		

REGISTERED PROFESSIONAL ENGINEER OREGON Sept. 23, 1977 HAL H. HEITMEYER

R.A.Wright engineering INC
consulting engineers
1340 SW Bertha Blvd
Portland, Oregon 97219
503 246 4293

OWNER
CITY OF TUALATIN
P.O.BOX 369
18880 S.W. MARTINAZZI AVENUE
TUALATIN, OREGON 97062

STREET IMPROVEMENTS — TUALATIN, OREGON

UTILITY IMPROVEMENTS
BOONES FERRY RD. AND WARM SPRINGS ST.

No.	REVISION	DATE	BY
4	AS-BUILT	3-85	CH
3	ADDED TONKA RD & SHALLOW MANHOLE	12-30-83	JMW
2	REVISED 12" WATERLINE IN B.F. ROAD	11-17-83	JRH
Δ	EXTENDED SAN. SEWER + ADDED 6" B.O.	10-4-83	JRH

SHEET OF 5 4
DRAWING NUMBER 782-1